


# CORNER RECORD

Document Number 140803.101

City of UNINCORPORATED AREA County of Nevada \_\_\_\_\_, California

Brief Legal Description PARCEL 1 OF PM 12-156 PTN OF NW 1/4 OF THE SE 1/4 OF SEC 3, T14 N, R. B. E' MDM

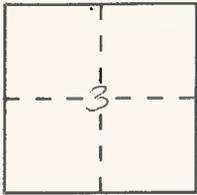

### CORNER TYPE

- Government Corner
- Meander
- Rancho
- Date of Survey \_\_\_\_\_
- Control
- Property
- Other

### COORDINATES (Optional)

N. \_\_\_\_\_  
 E. \_\_\_\_\_  
 Zone \_\_\_\_\_ Datum \_\_\_\_\_  
 Elev. \_\_\_\_\_

Corner — Left as found  Found and tagged  Established  Reestablished  Rebuilt

Identification and type of corner found: Evidence used to identify or procedure used to establish or reestablish the corner:

LOCATED CORNERS ESTABLISHED AS PER PM 12-156, REPLACED MISSING CORNERS AND SET LINE POINTS.

A description of the physical condition of the monument as found and as set or reset:

SET 5/8" REBAR WITH PLASTIC CAP STAMPED LS 6792 AND RAILROAD SPIKE AS SHOWN ON SKETCH MAP

### SURVEYOR'S STATEMENT

This Corner Record was prepared by me or under my direction in conformance with the Land Surveyors' Act on JUNE 24 <sup>2002</sup> ~~19~~ \_\_\_\_\_.

Signed [Signature] L.S. or R.C.E. Number 6792  
~~EXP. 6-30-2004~~  
 EXP. 9-30-2010




### COUNTY SURVEYOR'S STATEMENT

This Corner Record was received June 2, 2010 ~~19~~ \_\_\_\_\_ and examined and filed June 3, 2010 ~~19~~ \_\_\_\_\_.

Signed [Signature] Title County Surveyor



County Surveyor's Comment \_\_\_\_\_

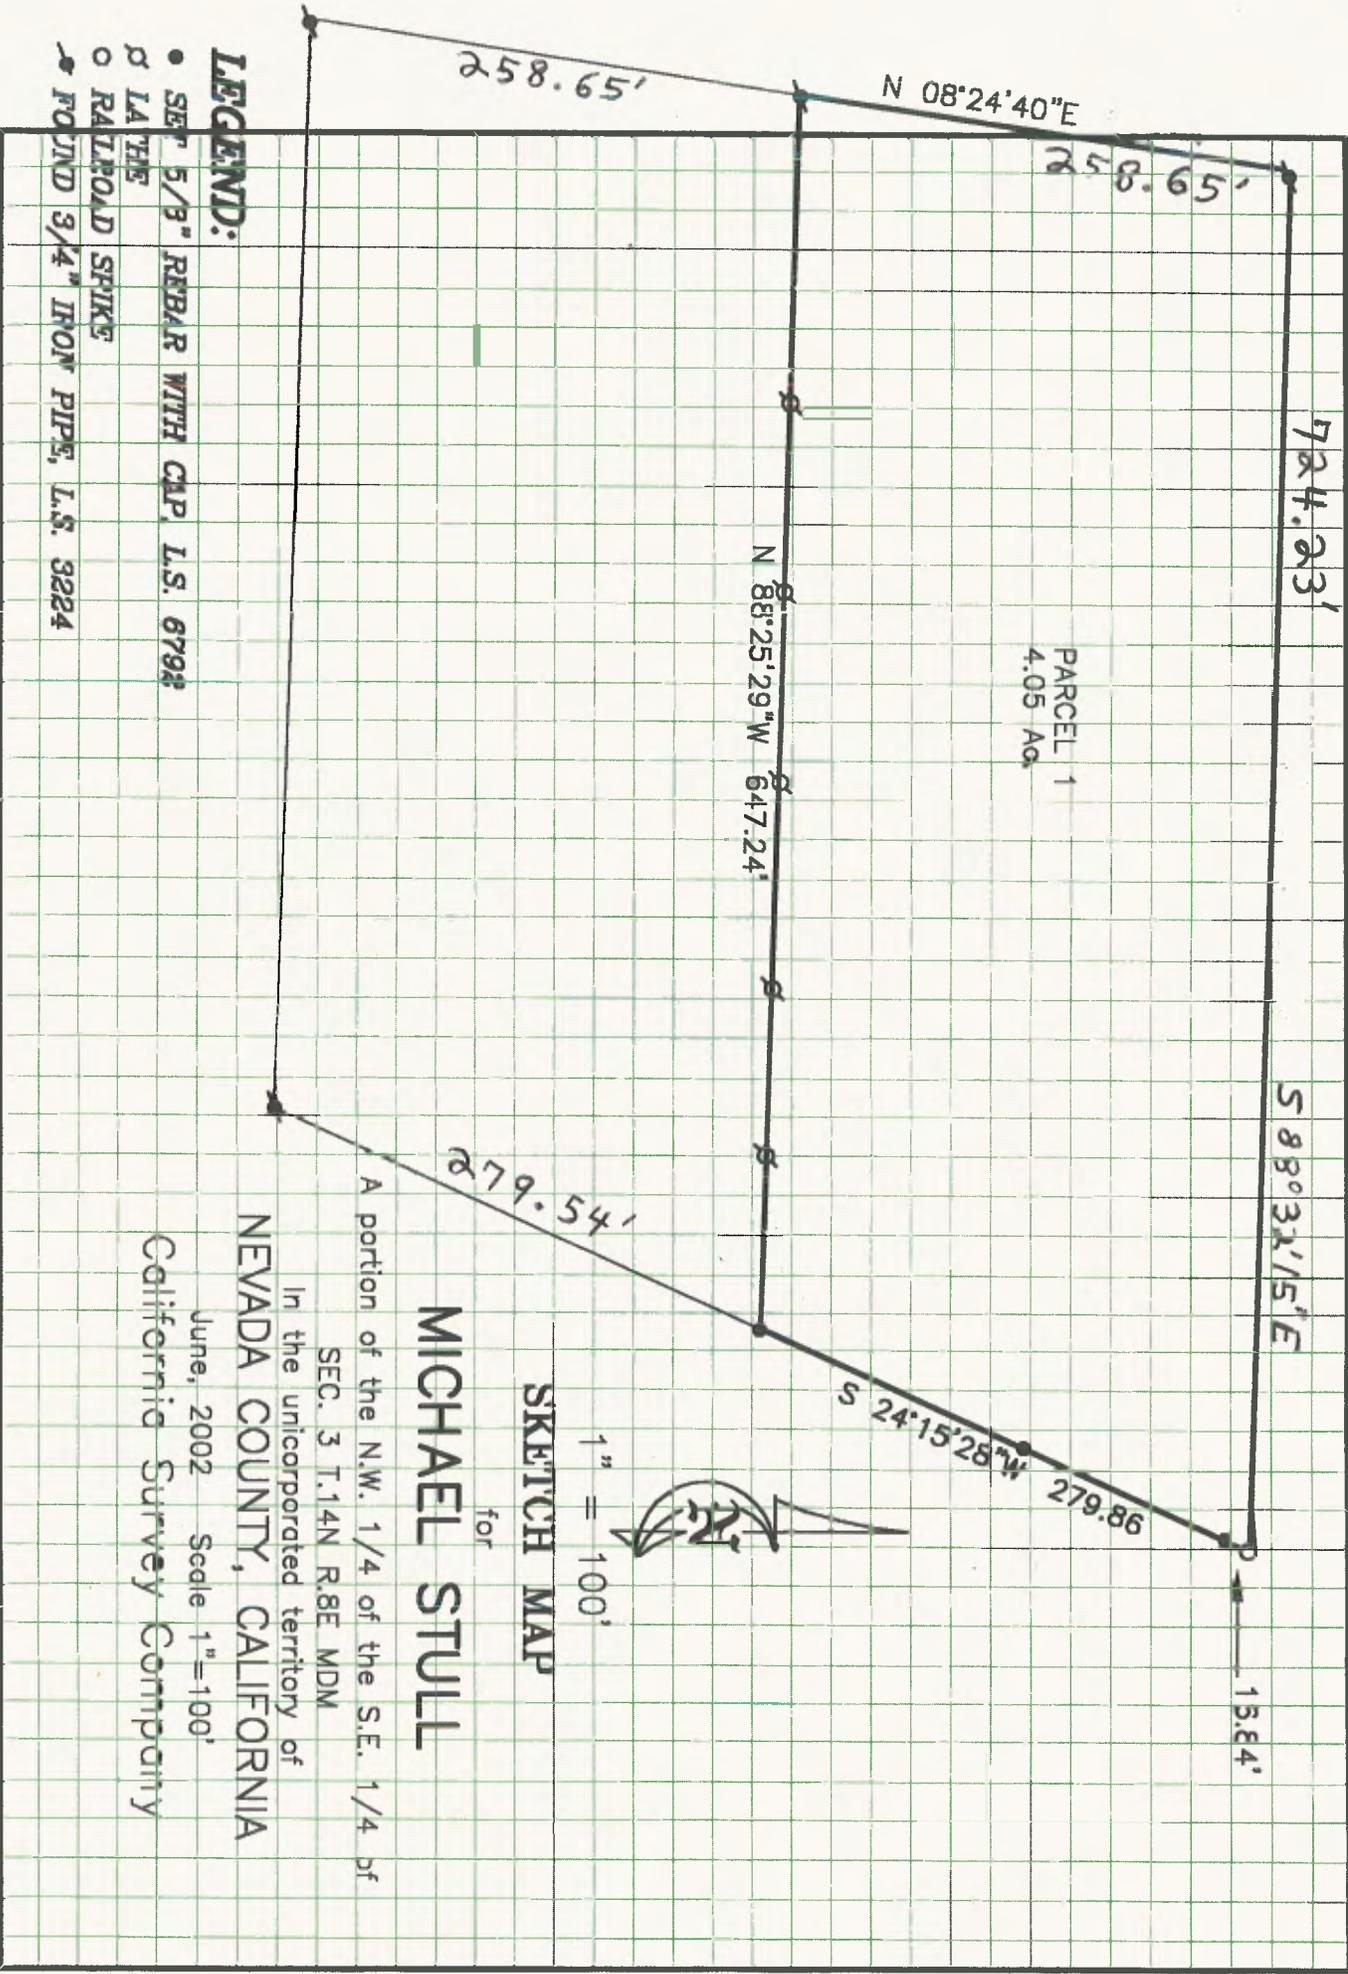

PARCEL 1  
4.05 AC.

**LEGEND:**

- SET 5/8" REBAR WITH CAP, L.S. 6792
- LATH
- RAIPOLD SPIKE
- FOUND 3/4" IRON PIPE, L.S. 3224

**SKETCH MAP**

for

**MICHAEL STULL**

A portion of the N.W. 1/4 of the S.E. 1/4 of  
 SEC. 3 T.14N R.8E MDN  
 In the unincorporated territory of  
**NEVADA COUNTY, CALIFORNIA**  
 June, 2002 Scale 1"=100'  
 California Survey Company

1" = 100'

