

CORNER RECORD

Document Number 140826.136

City of _____ County of Nevada _____, California

Brief Legal Description Lot No. 878 Western Lake Properties Unit No. 2A



T. 14 N.
R. 8 E.

CORNER TYPE

Government Corner Control
 Meander Property
 Rancho Other
 Date of Survey 04/28/08

COORDINATES (Optional)

N. _____
 E. _____
 Zone _____ Datum _____
 Elev. _____

Corner — Left as found Found and tagged Established Reestablished Rebuilt

Identification and type of corner found: Evidence used to identify or procedure used to establish or reestablish the corner:

Reset the exterior corners of Lot No. 878 of Western Lake Properties
Unit No. 2A, as recorded in Book 2 of Maps at Page 89, Nevada County Records
as per diagram on the reverse side of this page.

A description of the physical condition of the monument as found and as set or reset: _____


See reverse side.

SURVEYOR'S STATEMENT

This Corner Record was prepared by me or under my direction in conformance with _____
 the Land Surveyors' Act on April 28, 2008 ~~XX~~.

Signed [Signature] L.S. or R.C.E. Number LS 4415

Exp. 09/30/09

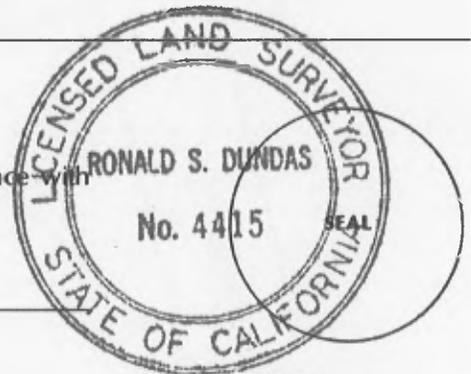

COUNTY SURVEYOR'S STATEMENT

This Corner Record was received April 29, 2008 ~~18~~ and examined
 and filed April 29, 2008 ~~18~~.

Signed [Signature] Title County Surveyor



County Surveyor's Comment _____

WESTERN LAKE PROPERTIES
JNT NO. 2A



Scale 1"=100'

