


CORNER RECORD

Document Number 140835.103

COUNTY NEVADA

County of NEVADA, California

Brief Legal Description LAKE OF THE PINES UNIT 2-B, BK 2 SUBD PG 95 LOT #1325 and 1323

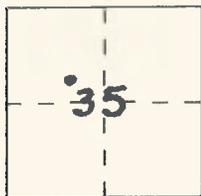

T14N, R8E

CORNER TYPE

COORDINATES (Optional)

- Government Corner
- Meander
- Rancho
- Date of Survey _____
- Control
- Property
- Other

N. _____
 E. _____
 Zone _____ Datum _____
 Elev. _____

Corner — Left as found Found and tagged Established Reestablished Rebuilt

Identification and type of corner found: Evidence used to identify or procedure used to establish or reestablish the corner:

USING FOUND ORIGINAL MONUMENTS AS SHOWN REESTABLISHED MISSING CORNER MONUMENTS IN RECORD POSITION.

A description of the physical condition of the monument as found and as set or reset: FOUND ORIGINAL MONUMENTS ARE 3/4" IRON PIPES, SOME WITH OLD PLASTIC PLUG STAMPED RCE 8199, OTHERS NO PLUG. FOUND MONUMENTS CHECKED WELL FOR POSITION. AT MISSING POSITIONS SET 5/8" REBAR WITH 2" ALUM CAP STAMPED LS 4728. AT SW CORNER SET SAME STAMPED 2.0' W.C

SURVEYOR'S STATEMENT

This Corner Record was prepared by me or under my direction in conformance with the Land Surveyors' Act on FEB 24 ~~19~~ 2000


Signed John C. Spencer L.S. or R.C.E. Number 4728




COUNTY SURVEYOR'S STATEMENT

This Corner Record was received February 28 ~~19~~ 2000 and examined and filed March 2 ~~19~~ 2000


Signed Thomas P. Martin Title Deputy County Surveyor

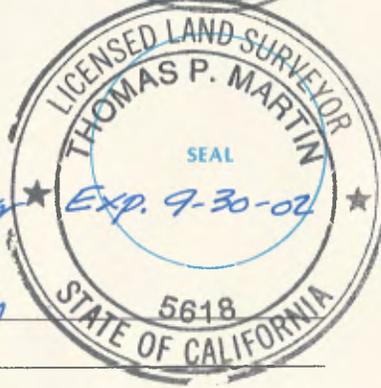

County Surveyor's Comment This Corner Record is for property in Section 35, T. 14 N., R. 8 E.

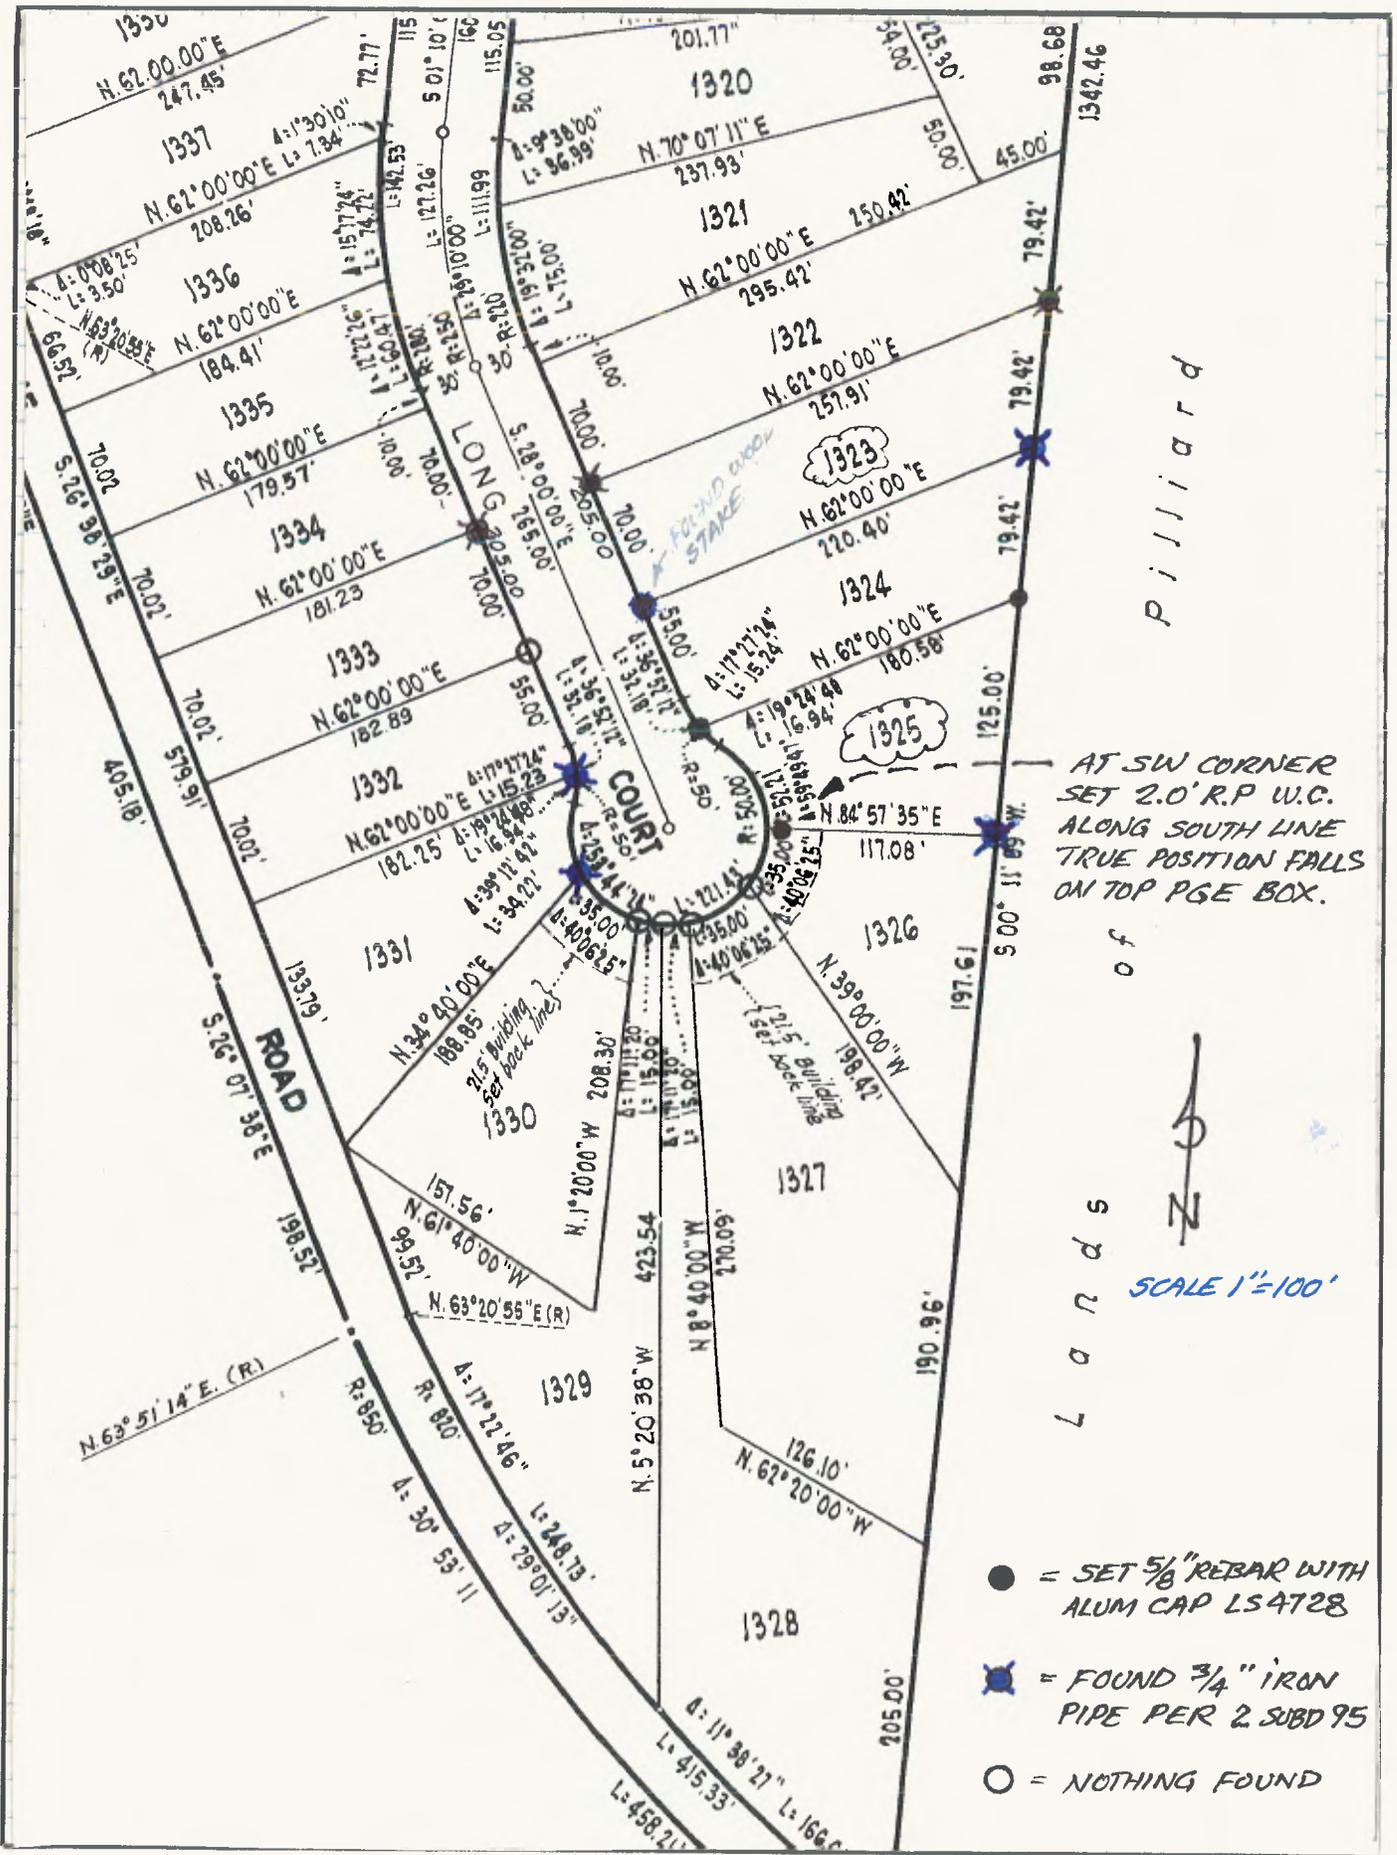

AT SW CORNER
SET 2.0' R.P. W.C.
ALONG SOUTH LINE
TRUE POSITION FALLS
ON TOP PGE BOX.

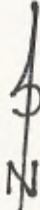of

 SCALE 1"=100'

- = SET 5/8" REBAR WITH ALUM CAP LS4728
- ⊗ = FOUND 3/4" IRON PIPE PER 2 SUBD 95
- = NOTHING FOUND